

JANUARY 2022

# EAST BAY PLAIN SUBBASIN GROUNDWATER SUSTAINABILITY PLAN APPENDIX 4

PREPARED FOR

East Bay Municipal Utility District GSA and  
City of Hayward GSA



PREPARED BY

Luhdorff & Scalmanini Consulting Engineers  
Geosyntec  
Brown and Caldwell  
Environmental Science Associates  
Dr. Jean Moran  
Farallon Geographics



## **APPENDIX 4**

Appendix 4.A. EBMUD GSA Projects Supporting Information

Appendix 4.B. EBMUD GSA Management Actions Supporting Information

Appendix 4.C. Hayward GSA Projects Supporting Information


Appendix 4.D. Hayward GSA Management Actions Supporting Information

## APPENDIX 4.A.

### **EBMUD GSA Project Supporting Information**

## Appendix 4.A

### EBMUD GSA Project Supporting Information

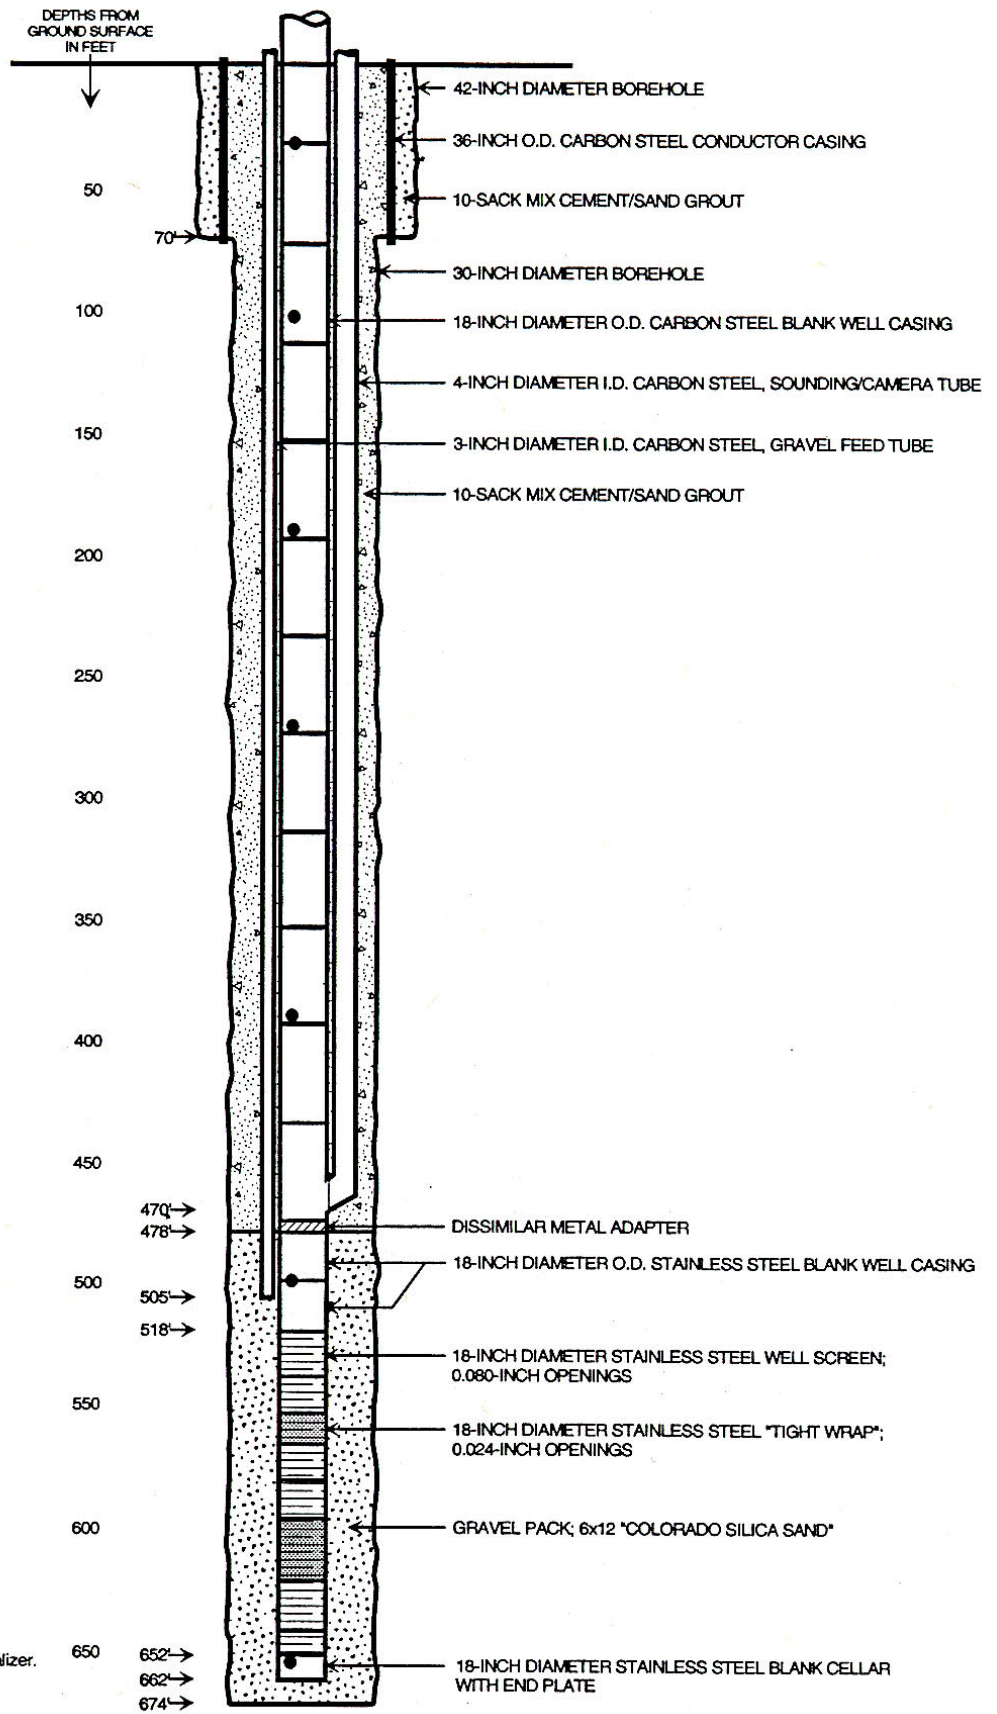


**FIGURE 2-5**  
**WELL DIAGRAM FOR BAYSIDE WELL NO. 1**  
 EAST BAY MUNICIPAL UTILITY DISTRICT  
 BAYSIDE GROUNDWATER PROJECT  
 DRAFT EIR

Source: Fugro 1998

# Future Scenario

## Pumping and Injection of Future Projects

### Groundwater Pumping/Injection in Acre-Feet (AF)

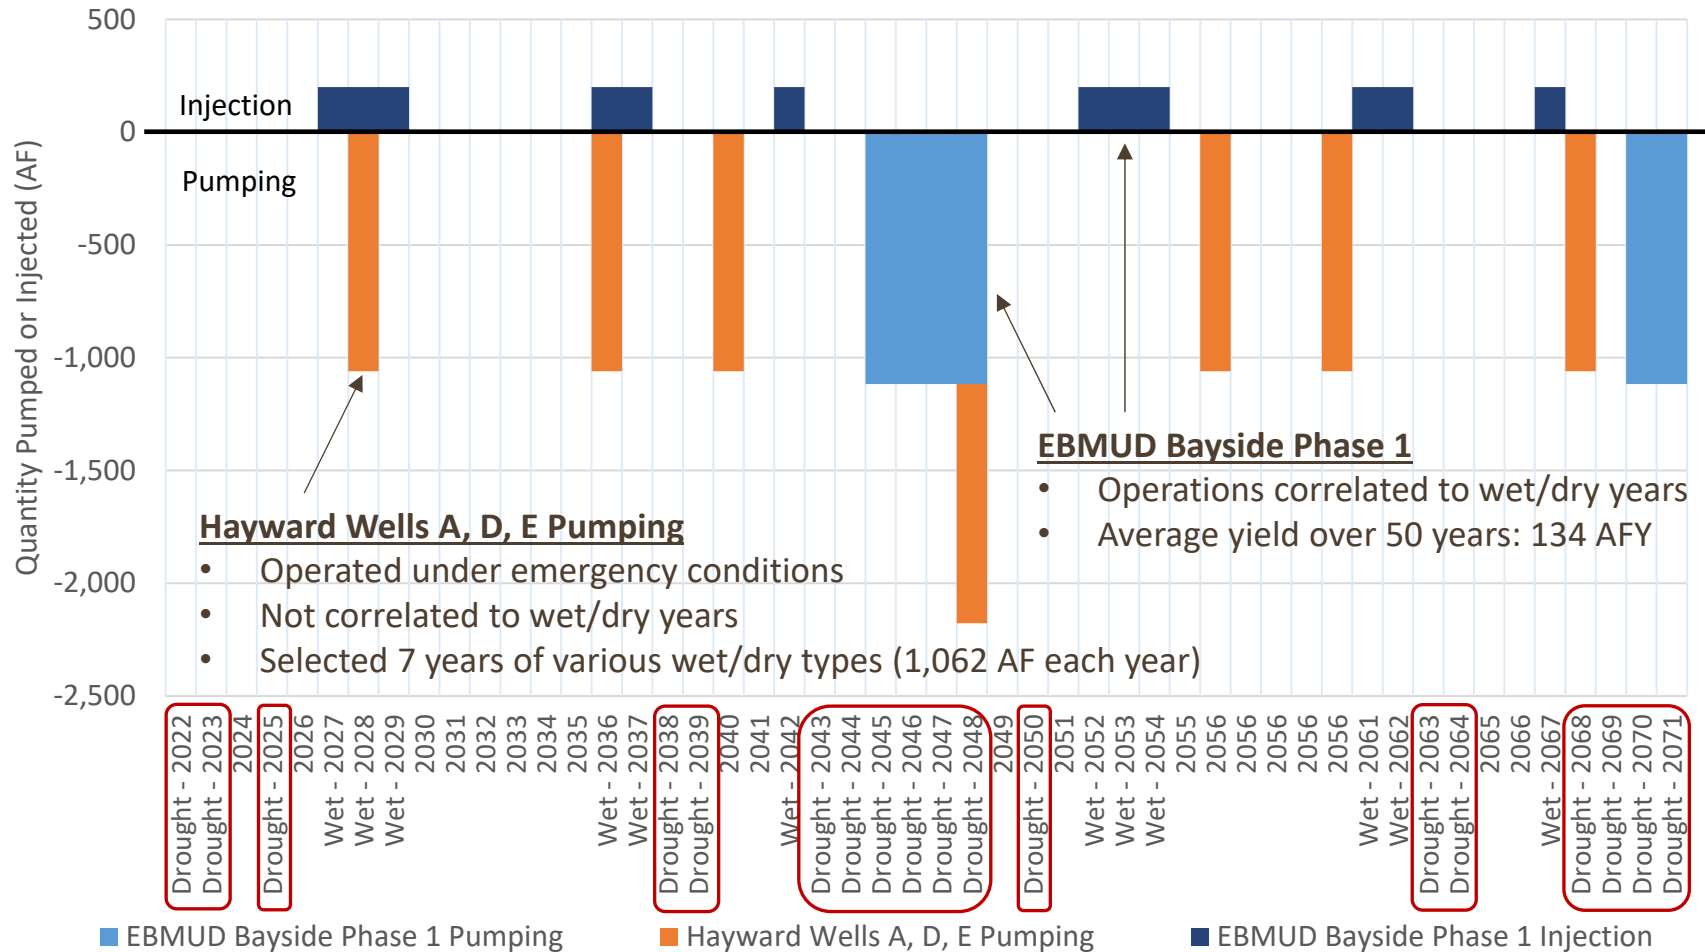

## APPENDIX 4.B.

### **EBMUD GSA Management Actions Supporting Information**

Table 4B-1. EBMUD Management Action Implementation Costs

| Work Item   | 2022             | 2023             | 2024               | 2025             | 2026             | 2027             | 2028             | 2029             | 2030             | 2031             | 10-Year Total      | Initial 5-Year Total |
|---|------------------|------------------|--------------------|------------------|------------------|------------------|------------------|------------------|------------------|------------------|--------------------|----------------------|
| Annual Reporting  | \$48,750         | \$32,500         | \$32,500           | \$32,500         | \$32,500         | \$32,500         | \$32,500         | \$32,500         | \$32,500         | \$32,500         | \$341,250          | \$178,750            |
| Data Management System  | \$5,000          | \$5,000          | \$5,000            | \$5,000          | \$5,000          | \$5,000          | \$5,000          | \$5,000          | \$5,000          | \$5,000          | \$50,000           | \$25,000             |
| GSP 5-year Updates  |                  |                  |                    |                  | \$162,500        |                  |                  |                  |                  | \$162,500        | \$325,000          | \$162,500            |
| RMS GW Level Monitoring                                       | \$14,500         | \$14,500         | \$14,500           | \$14,500         | \$14,500         | \$14,500         | \$14,500         | \$14,500         | \$14,500         | \$14,500         | \$145,000          | \$72,500             |
| Monitoring Network (in addition to RMS Wells)                 | \$20,000         | \$20,000         | \$20,000           | \$20,000         | \$20,000         | \$20,000         | \$20,000         | \$20,000         | \$20,000         | \$20,000         | \$200,000          | \$100,000            |
| Baseline RMS WQ Sampling                                      |                  |                  | \$44,000           | \$44,000         |                  |                  |                  |                  |                  |                  | \$88,000           | \$88,000             |
| RMS WQ Sampling (TDS, nitrate, arsenic, chloride)             | \$22,000         | \$22,000         | \$22,000           | \$22,000         | \$22,000         | \$22,000         | \$22,000         | \$22,000         | \$22,000         | \$22,000         | \$220,000          | \$110,000            |
| Update WQ Plume Info  |                  | \$6,500          |                    | \$6,500          |                  | \$6,500          |                  | \$6,500          |                  | \$6,500          | \$32,500           | \$13,000             |
| Fate & Transport Modeling                                     |                  |                  |                    |                  | \$65,000         |                  |                  |                  |                  | \$65,000         | \$130,000          | \$65,000             |
| Extensometer Monitoring                                       | \$15,500         | \$15,500         | \$15,500           | \$15,500         | \$15,500         | \$15,500         | \$15,500         | \$15,500         | \$15,500         | \$15,500         | \$155,000          | \$77,500             |
| Shallow Wells Near Creeks (10)                                |                  |                  | \$115,000          |                  |                  |                  |                  |                  |                  |                  | \$115,000          | \$115,000            |
| Shallow Well Level Monitoring                                 |                  |                  | \$7,000            | \$7,000          | \$7,000          | \$7,000          | \$7,000          | \$7,000          | \$7,000          | \$7,000          | \$56,000           | \$21,000             |
| Shallow Well WQ Monitoring                                    |                  |                  | \$10,000           | \$10,000         | \$10,000         | \$10,000         | \$10,000         | \$10,000         | \$10,000         | \$10,000         | \$80,000           | \$30,000             |
| Install New Nested Wells (3)                                  |                  |                  | \$400,000          |                  |                  |                  |                  |                  |                  |                  | \$400,000          | \$400,000            |
| New Nested Wells GW Level Monitoring                          |                  |                  | \$7,000            | \$7,000          | \$7,000          | \$7,000          | \$7,000          | \$7,000          | \$7,000          | \$7,000          | \$56,000           | \$21,000             |
| New Nested Wells WQ Sampling                                  |                  |                  | \$10,000           | \$10,000         | \$10,000         | \$10,000         | \$10,000         | \$10,000         | \$10,000         | \$10,000         | \$80,000           | \$30,000             |
| Install Stream Gages (2)                                      |                  |                  | \$32,500           | \$32,500         |                  |                  |                  |                  |                  |                  | \$65,000           | \$65,000             |
| Stream Gauge Monitoring                                       |                  |                  | \$17,500           | \$35,000         | \$35,000         | \$35,000         | \$35,000         | \$35,000         | \$35,000         | \$35,000         | \$262,500          | \$87,500             |
| Synoptic Stream Monitoring                                    | \$15,000         | \$15,000         | \$15,000           | \$15,000         | \$15,000         | \$15,000         | \$15,000         | \$15,000         | \$15,000         | \$15,000         | \$150,000          | \$75,000             |
| Isotopic Sampling   |                  |                  | \$100,000          |                  |                  |                  |                  |                  |                  |                  | \$100,000          | \$100,000            |
| Baseline Habitat Survey (1 Event)                             |                  |                  | \$150,000          |                  |                  |                  |                  |                  |                  |                  | \$150,000          | \$150,000            |
| Habitat Survey (Every 5 Years)                                |                  |                  |                    |                  | \$50,000         |                  |                  |                  |                  | \$50,000         | \$100,000          | \$50,000             |
| <b>Total (including capital costs; every five year costs)</b> | <b>\$140,750</b> | <b>\$131,000</b> | <b>\$1,017,500</b> | <b>\$276,500</b> | <b>\$471,000</b> | <b>\$200,000</b> | <b>\$193,500</b> | <b>\$200,000</b> | <b>\$193,500</b> | <b>\$477,500</b> | <b>\$3,301,250</b> | <b>\$2,036,750</b>   |
| <b>Total (ongoing annual costs only)</b>                      | <b>\$140,750</b> | <b>\$131,000</b> | <b>\$176,000</b>   | <b>\$200,000</b> | <b>\$193,500</b> | <b>\$200,000</b> | <b>\$193,500</b> | <b>\$200,000</b> | <b>\$193,500</b> | <b>\$200,000</b> | <b>\$1,828,250</b> | <b>\$841,250</b>     |

Costs above don't include EBMUD/Hayward Staff time to meet with stakeholders, provide Board updates, DMS capital costs/maintenance, etc.

Capital or one-time costs

Every five year costs




APPENDIX 4.C.

**Hayward GSA Projects Supporting Information**

## Appendix 4.C

### Hayward GSA Projects Supporting Information

91-2-109

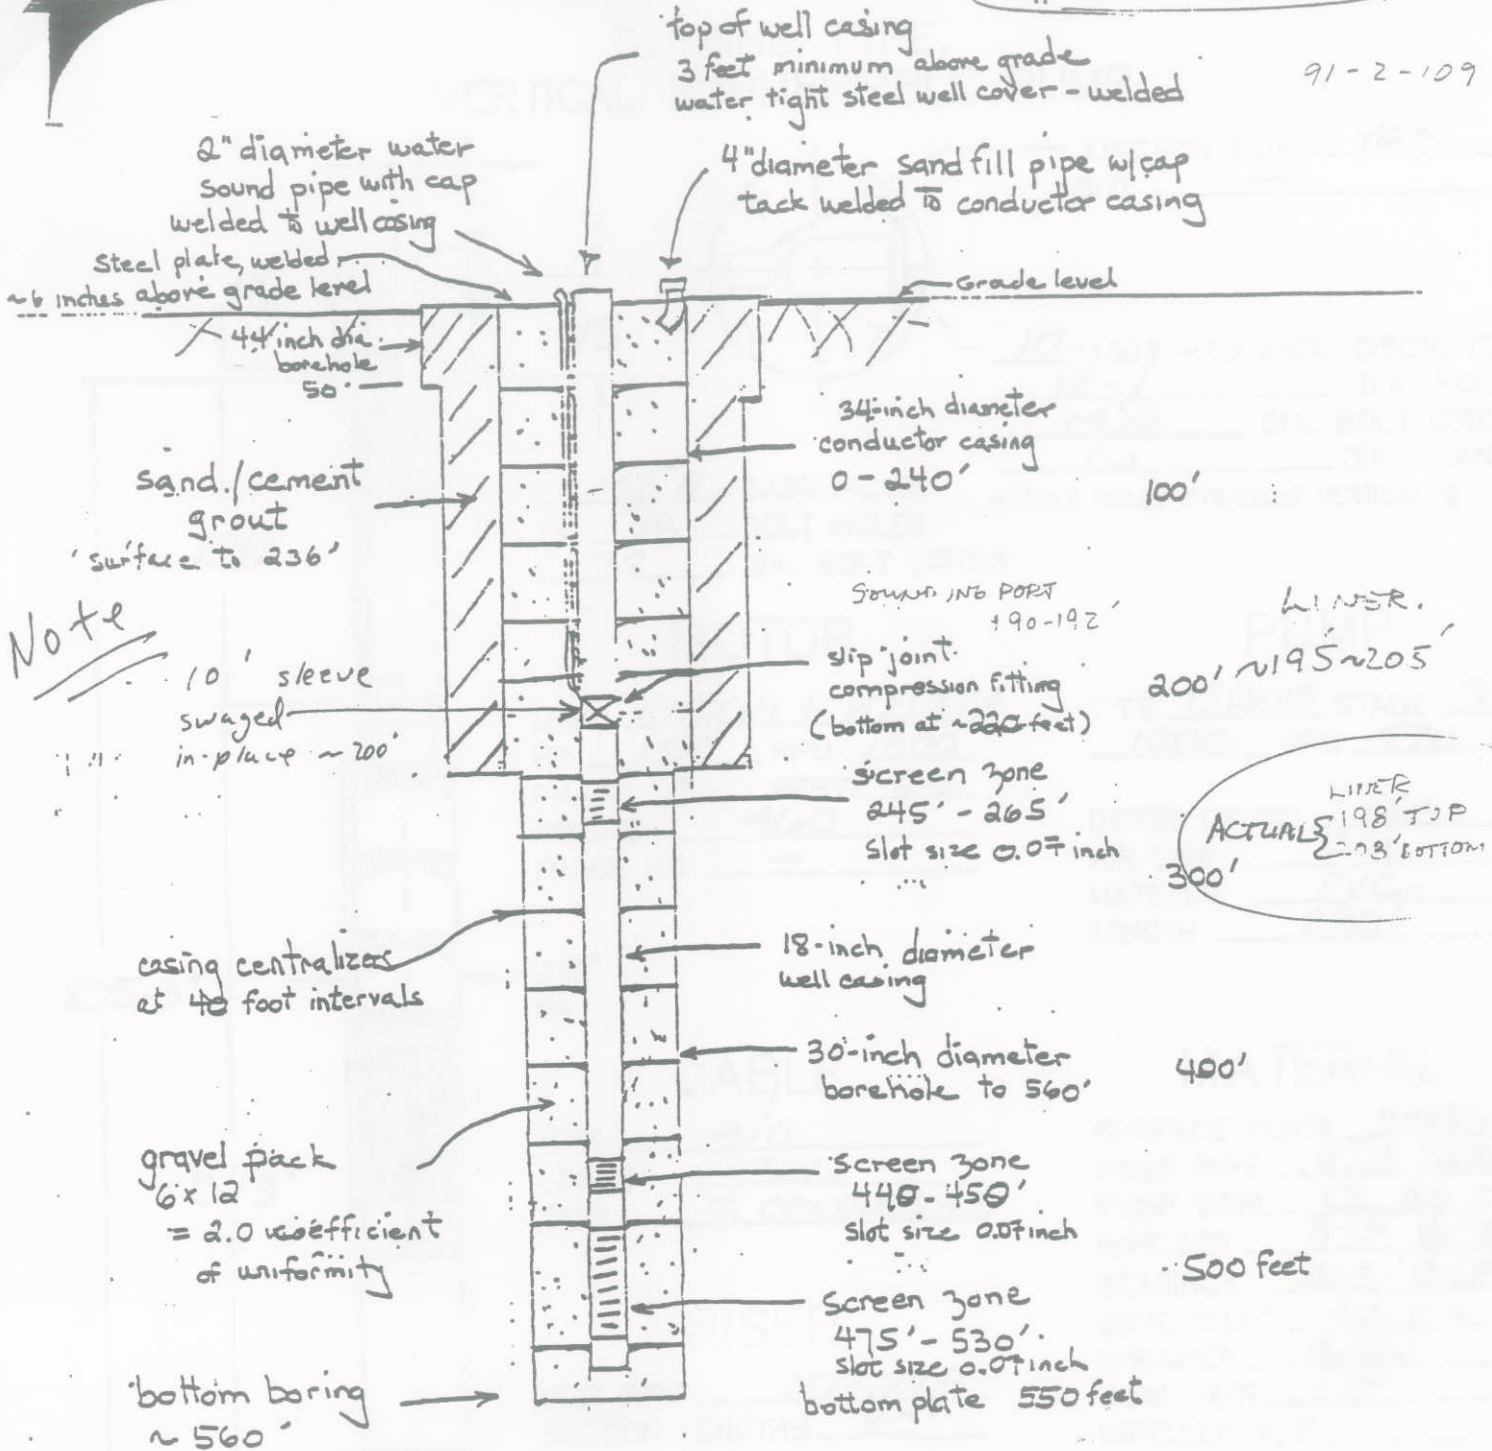


FINAL DESIGN OF  
EMERGENCY SUPPLY WELL No. 1


7/14/81

Prepared by  
AQUIFER SCIENCES INC. /  
ENTRIX INC.  
Rebecca Sterbenitz  
Grace Haggerty


**TEST HOLE LITHOLOGY**

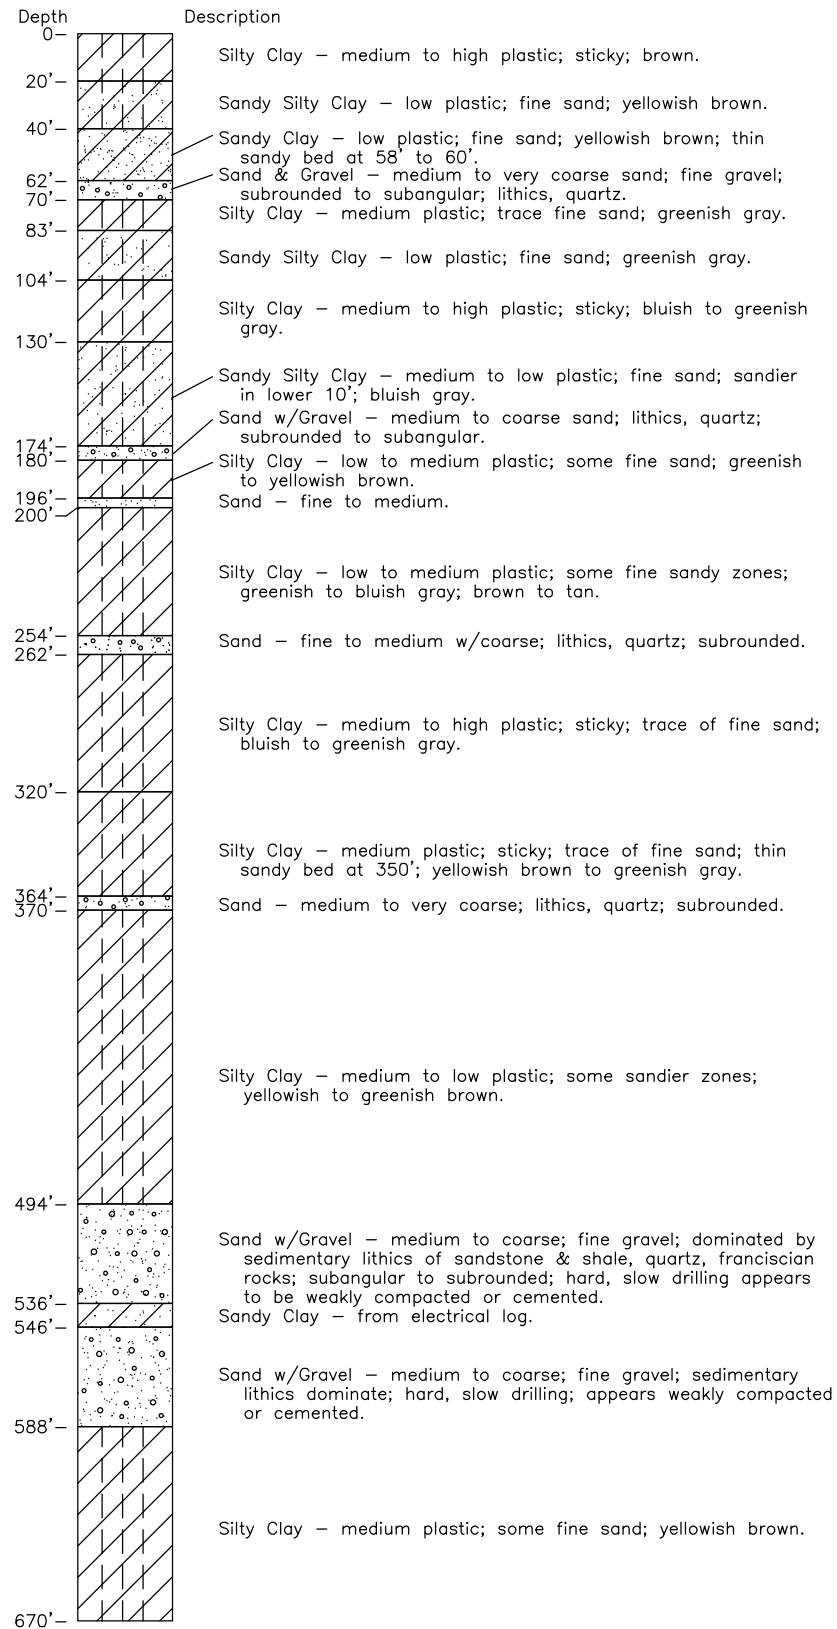

**TEST HOLE GEOPHYSICAL SURVEY**

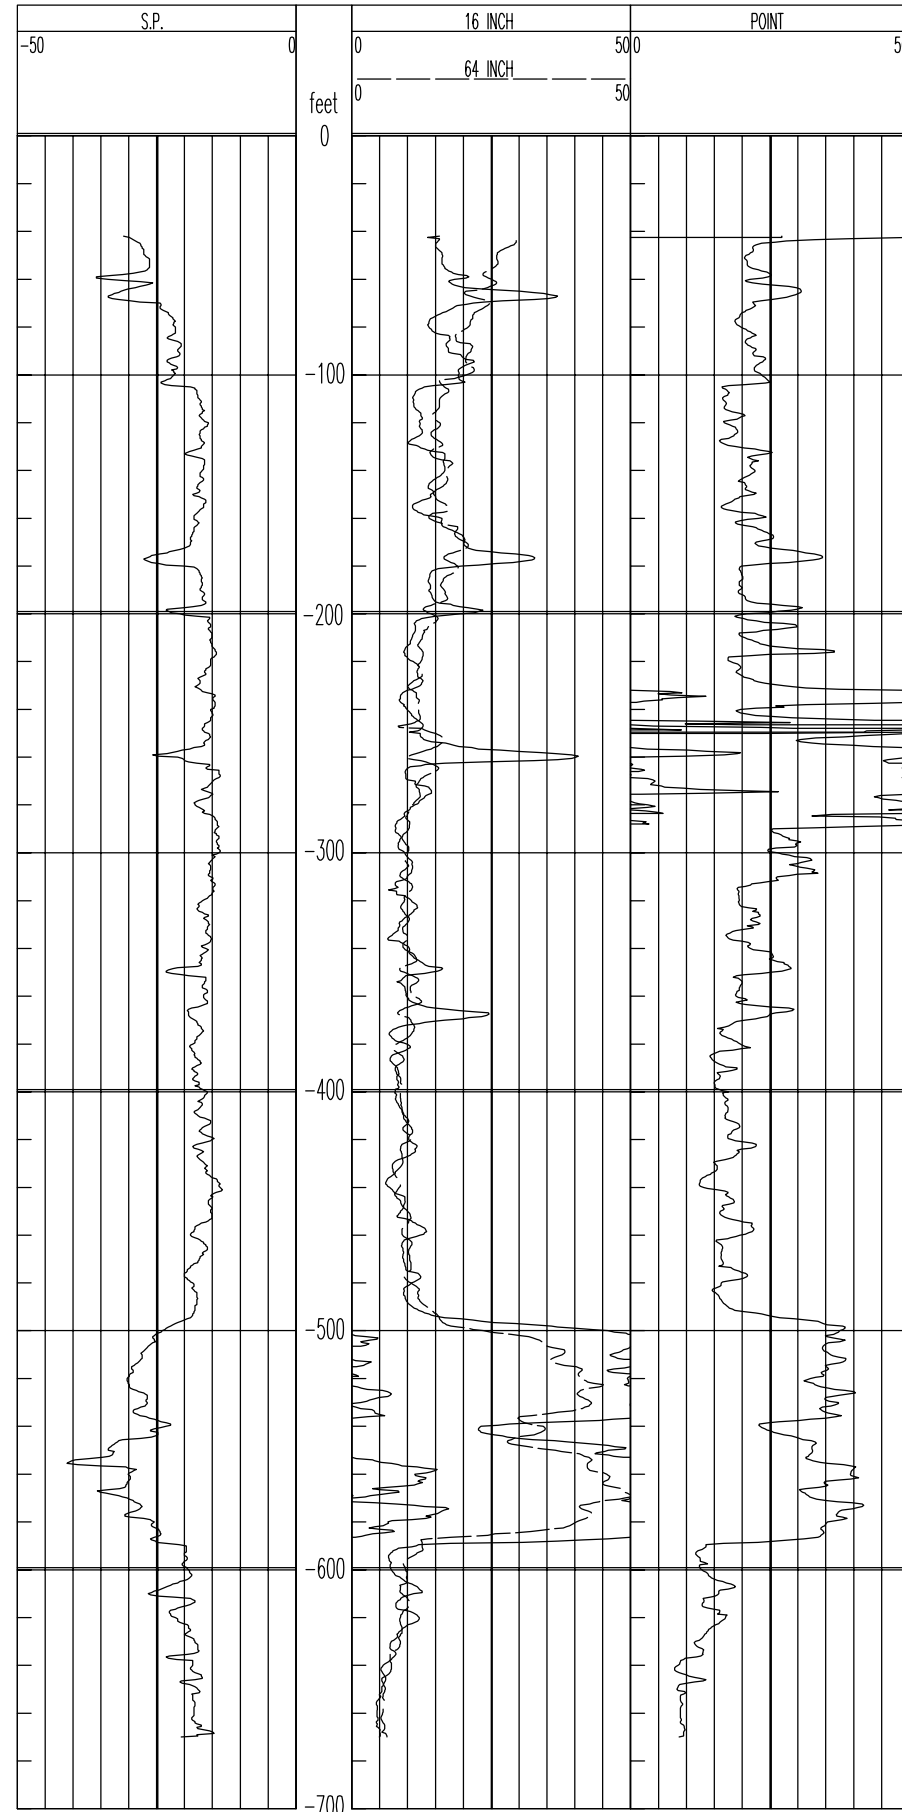

**WELL D-2 AS-BUILT**

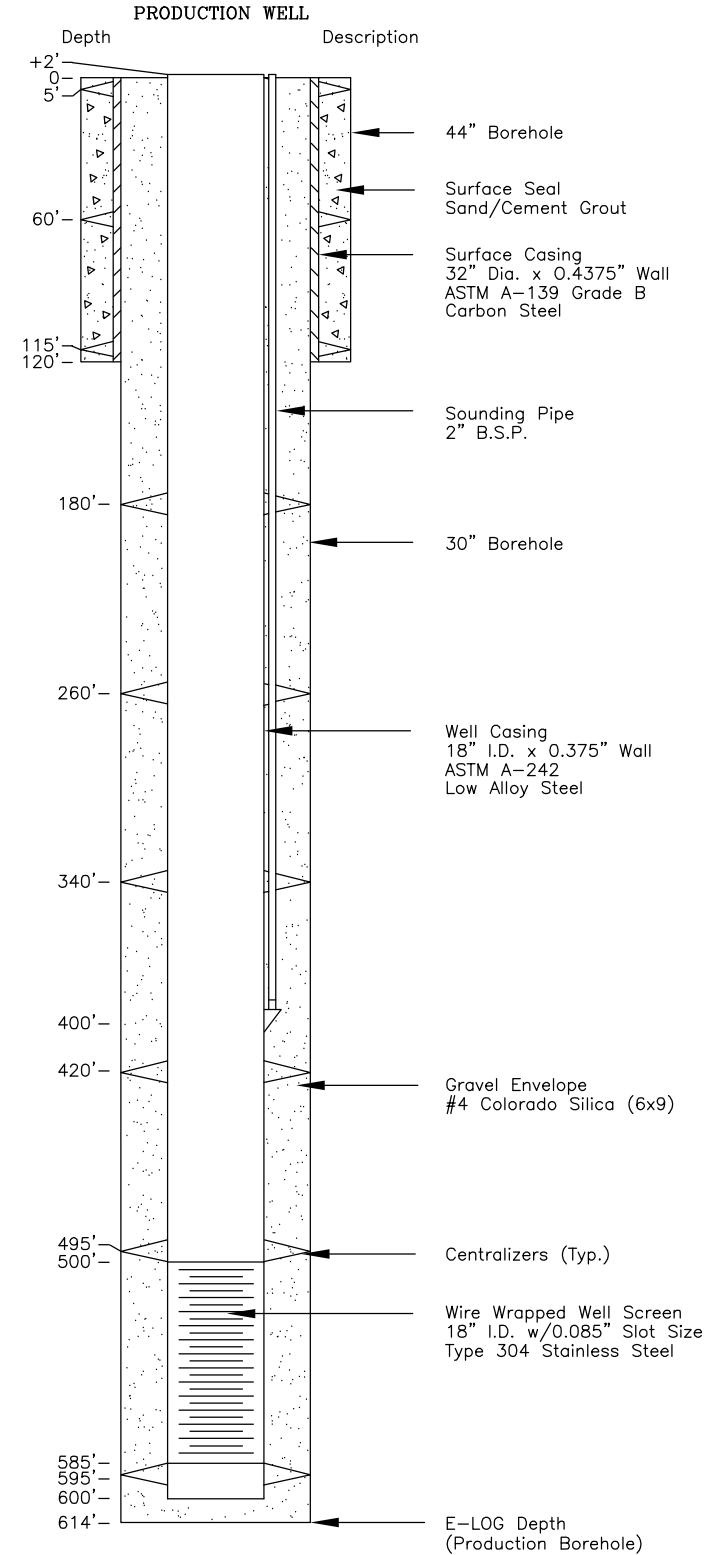

**AS-BUILT**

CAD FILE: C:\Projects\City of Hayward\95-2-132\Tehap\95-2-132.dwg DATE: 03-17-10 1:44pm

**EMERGENCY WATER SUPPLY WELL D**  
**PHASE I - DRILLING & CONSTRUCTION**  
**HAYWARD AIRPORT SITE**  
**WELL PROFILE**

**CITY OF HAYWARD**  
**DEPARTMENT OF PUBLIC WORKS**  
**ENGINEERING DIVISION**

DESIGNED BY: TDE/LCS  
 CHECKED BY: LHE  
 DRAWN BY: LDC  
 APPROVED BY: [Signature]

PROJ. NO.: 7103  
 DATE: JUNE 1993  
 SCALE: 1" = 40'


**LUHDORFF & SCALMANINI**  
 Consulting Engineers  
 Woodland, California 95695  
 92-2-085 TEHAP3

REVISIONS:


| REV. | DATE | DESCRIPTION | BY |
|------|------|-------------|----|
|      |      |             |    |

TOTAL SHEETS: 5  
 FILE NO.: E-1300  
 SHEET NO.: 3

**Test Hole Lithology**

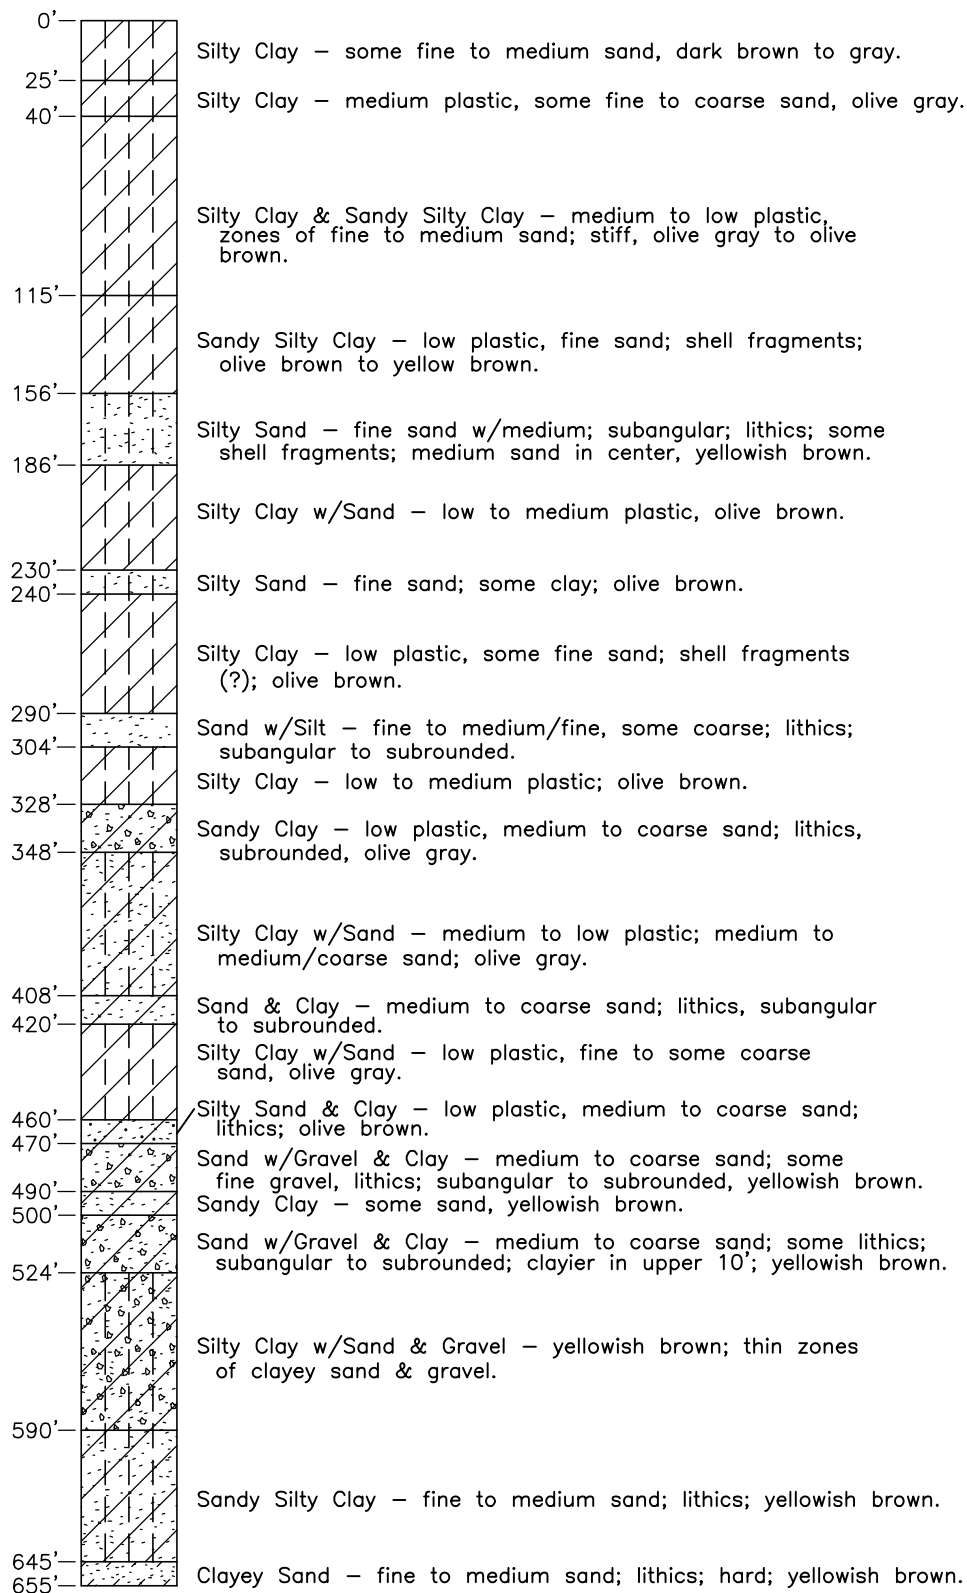


**Test Hole Electrical Log**

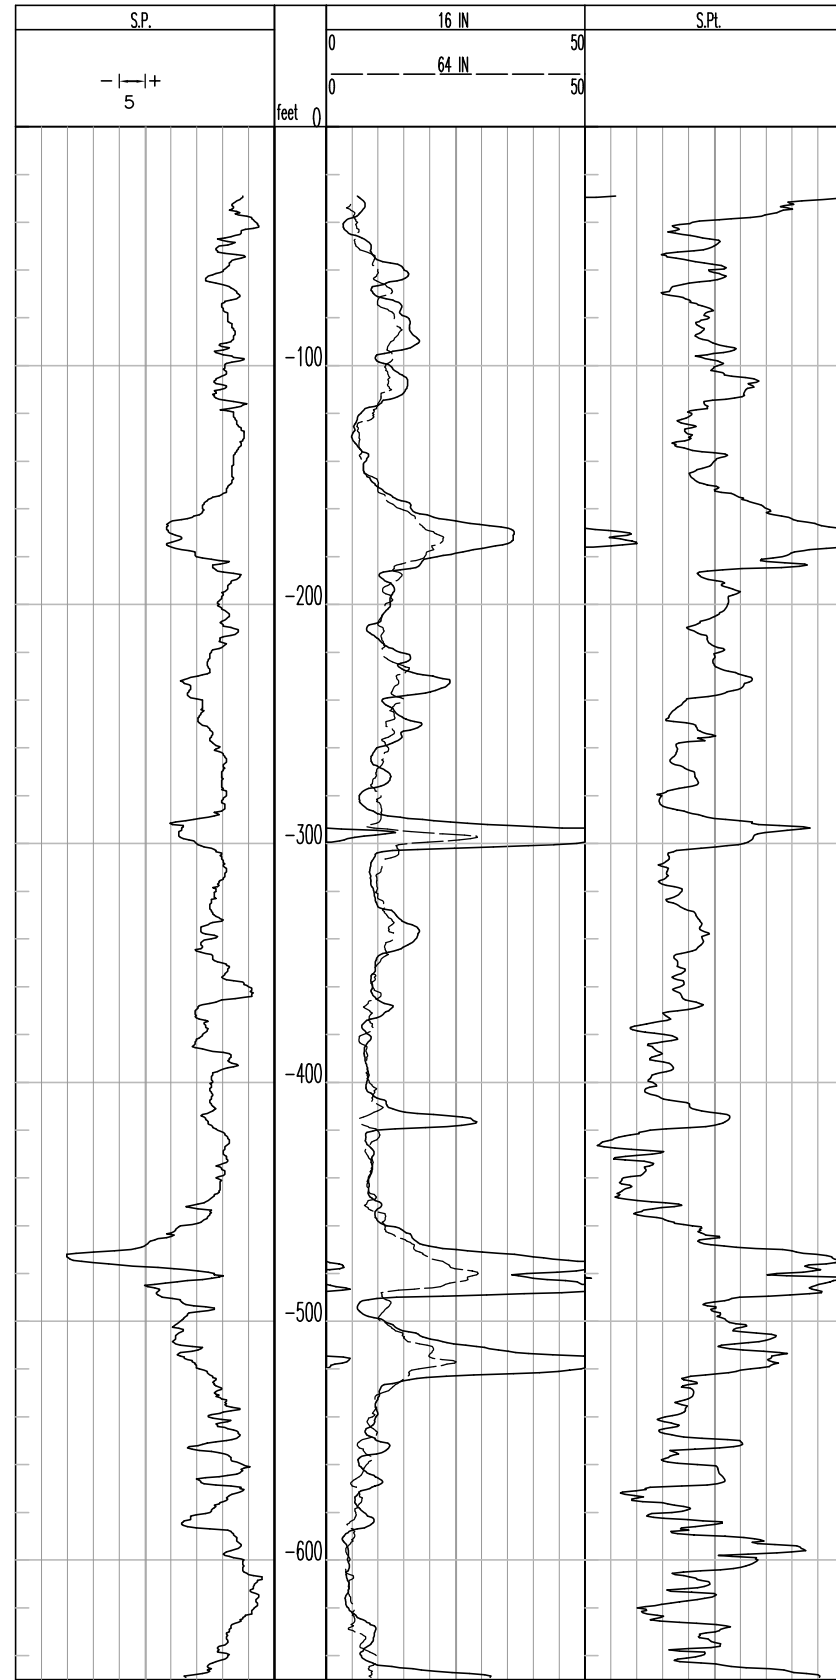

E-Log by WELENCO 4/8/98

**Water Supply Well E**

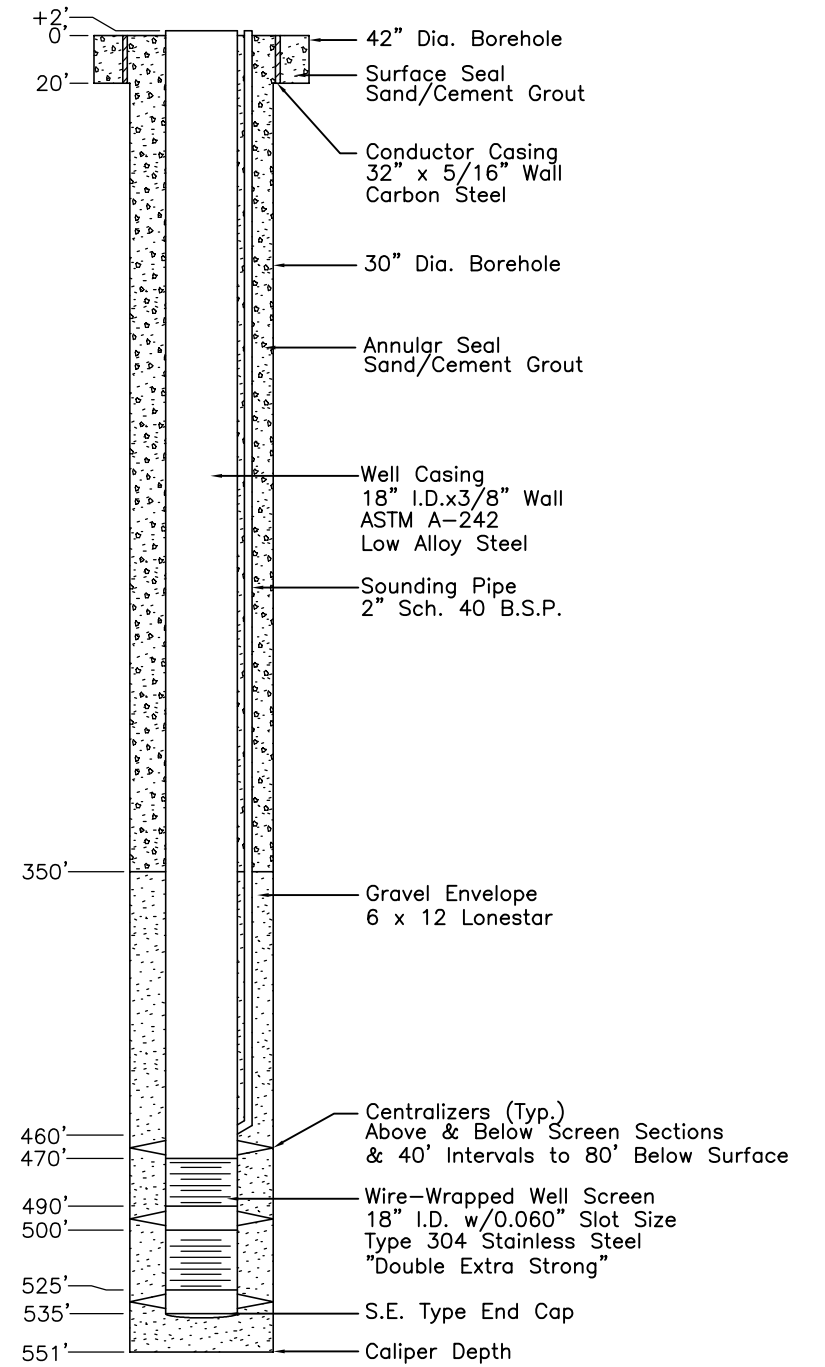

EMERGENCY WATER SUPPLY WELL E  
28251 INDUSTRIAL BLVD.

CITY OF HAYWARD  
DEPARTMENT OF PUBLIC WORKS  
ENGINEERING DIVISION

DESIGNED BY: TDE/LCS  
CHECKED BY: LDC  
APPROVED BY: [Signature]

DATE: JAN 1999

PROJ. NO.: 7110

SCALE: NONE

WELL PROFILE

TOTAL SHEETS: 6  
FILE NO.: E-1498  
SHEET NO.: 4

LUHDORFF & SCALMANINI  
Consulting Engineers  
Woodland, California 95695  
98-2-011 HW2.DWG


DESIGN ENGINEER'S STAMP

**AS-BUILT**

# Future Scenario

## Pumping and Injection of Future Projects

### Groundwater Pumping/Injection in Acre-Feet (AF)

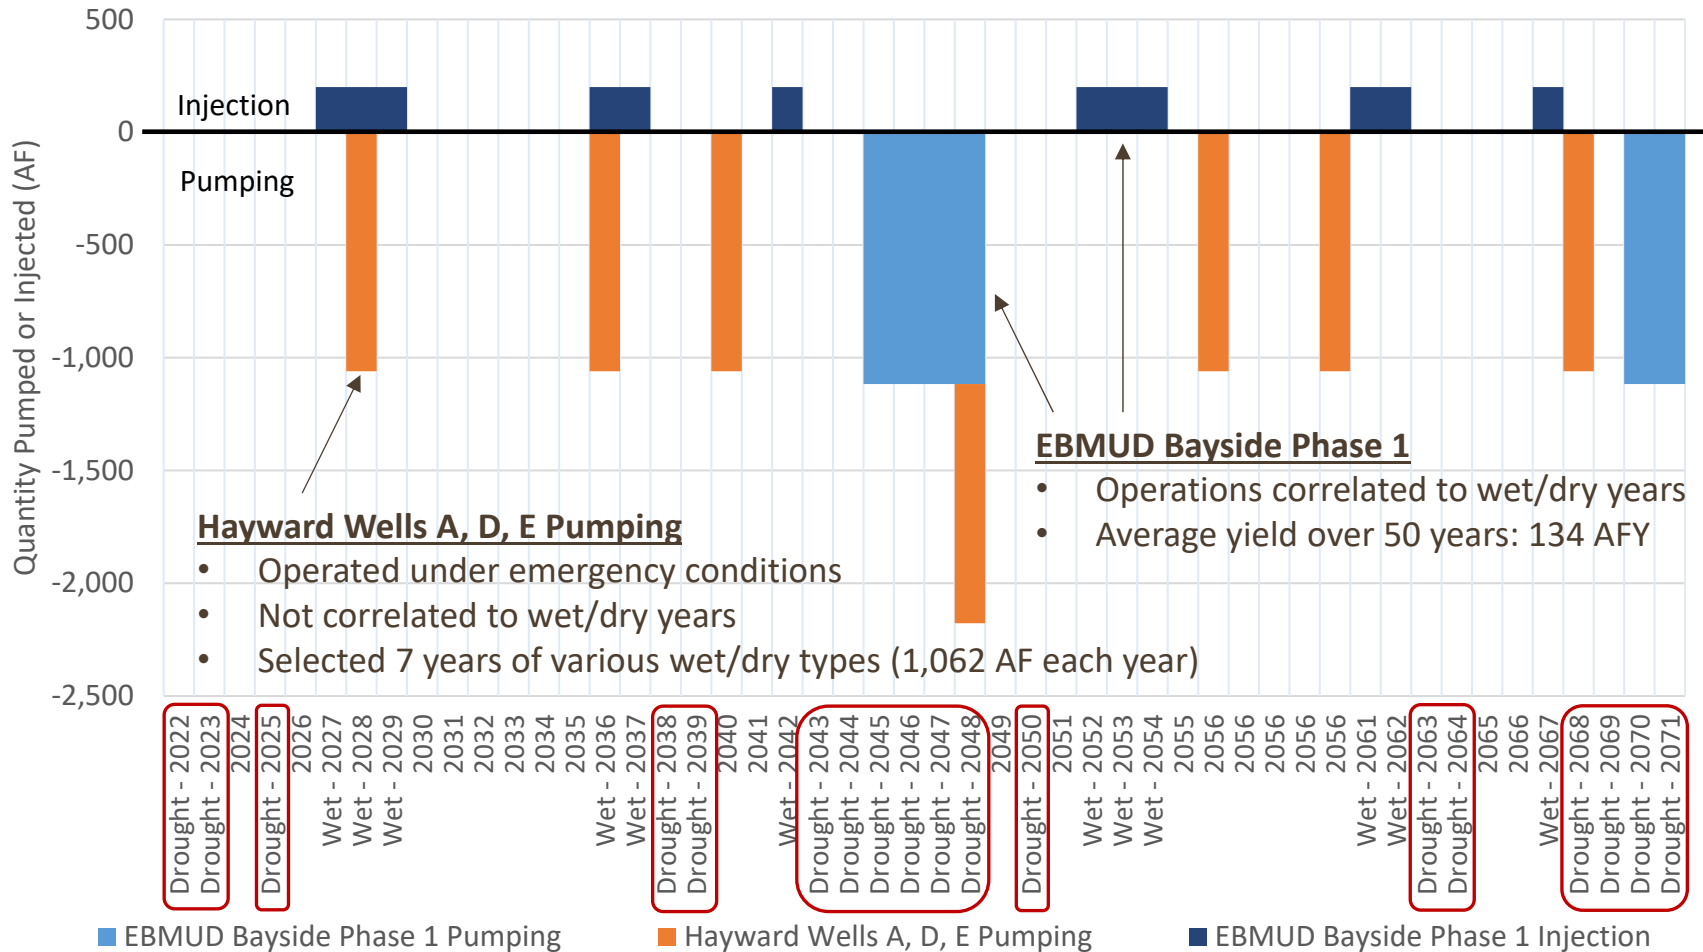

APPENDIX 4.D.

**Hayward GSA Management Actions Supporting Information**

Table 4D-1. Hayward Management Action Implementation Costs

| Work Item   | 2022            | 2023            | 2024            | 2025            | 2026             | 2027            | 2028            | 2029            | 2030            | 2031             | 10-Year Total    | Initial 5-Year Total |
|---|-----------------|-----------------|-----------------|-----------------|------------------|-----------------|-----------------|-----------------|-----------------|------------------|------------------|----------------------|
| Annual Reporting  | \$26,250        | \$17,500        | \$17,500        | \$17,500        | \$17,500         | \$17,500        | \$17,500        | \$17,500        | \$17,500        | \$17,500         | \$183,750        | \$96,250             |
| Data Management System  | \$5,000         | \$5,000         | \$5,000         | \$5,000         | \$5,000          | \$5,000         | \$5,000         | \$5,000         | \$5,000         | \$5,000          | \$50,000         | \$25,000             |
| GSP 5-year Updates  |                 |                 |                 |                 | \$87,500         |                 |                 |                 |                 | \$87,500         | \$175,000        | \$87,500             |
| RMS GW Level Monitoring                                       | \$5,500         | \$5,500         | \$5,500         | \$5,500         | \$5,500          | \$5,500         | \$5,500         | \$5,500         | \$5,500         | \$5,500          | \$55,000         | \$27,500             |
| Monitoring Network (in addition to RMS Wells)                 | \$5,000         | \$5,000         | \$5,000         | \$5,000         | \$5,000          | \$5,000         | \$5,000         | \$5,000         | \$5,000         | \$5,000          | \$50,000         | \$25,000             |
| Baseline RMS WQ Sampling                                      |                 |                 | \$16,000        | \$16,000        |                  |                 |                 |                 |                 |                  | \$32,000         | \$32,000             |
| RMS WQ Sampling (TDS, nitrate, arsenic, chloride)             | \$8,000         | \$8,000         | \$8,000         | \$8,000         | \$8,000          | \$8,000         | \$8,000         | \$8,000         | \$8,000         | \$8,000          | \$80,000         | \$40,000             |
| Update WQ Plume Info  |                 | \$3,500         |                 | \$3,500         |                  | \$3,500         |                 | \$3,500         |                 | \$3,500          | \$17,500         | \$7,000              |
| Fate & Transport Modeling                                     |                 |                 |                 |                 | \$35,000         |                 |                 |                 |                 | \$35,000         | \$70,000         | \$35,000             |
| Extensometer Monitoring                                       |                 |                 |                 |                 |                  |                 |                 |                 |                 |                  | \$0              | \$0                  |
| Shallow Wells Near Creeks (10)                                |                 |                 |                 |                 |                  |                 |                 |                 |                 |                  | \$0              | \$0                  |
| Shallow Well Level Monitoring                                 |                 |                 |                 |                 |                  |                 |                 |                 |                 |                  | \$0              | \$0                  |
| Shallow Well WQ Monitoring                                    |                 |                 |                 |                 |                  |                 |                 |                 |                 |                  | \$0              | \$0                  |
| Install New Nested Wells (3)                                  |                 |                 |                 |                 |                  |                 |                 |                 |                 |                  | \$0              | \$0                  |
| New Nested Wells GW Level Monitoring                          |                 |                 |                 |                 |                  |                 |                 |                 |                 |                  | \$0              | \$0                  |
| New Nested Wells WQ Sampling                                  |                 |                 |                 |                 |                  |                 |                 |                 |                 |                  | \$0              | \$0                  |
| Install Stream Gages (2)                                      |                 |                 |                 |                 |                  |                 |                 |                 |                 |                  | \$0              | \$0                  |
| Stream Gauge Monitoring                                       |                 |                 |                 |                 |                  |                 |                 |                 |                 |                  | \$0              | \$0                  |
| Synoptic Stream Monitoring                                    |                 |                 |                 |                 |                  |                 |                 |                 |                 |                  | \$0              | \$0                  |
| Isotopic Sampling   |                 |                 |                 |                 |                  |                 |                 |                 |                 |                  | \$0              | \$0                  |
| Baseline Habitat Survey (1 Event)                             |                 |                 |                 |                 |                  |                 |                 |                 |                 |                  | \$0              | \$0                  |
| Habitat Survey (Every 5 Years)                                |                 |                 |                 |                 |                  |                 |                 |                 |                 |                  | \$0              | \$0                  |
| <b>Total (including capital costs; every five year costs)</b> | <b>\$49,750</b> | <b>\$44,500</b> | <b>\$57,000</b> | <b>\$60,500</b> | <b>\$163,500</b> | <b>\$44,500</b> | <b>\$41,000</b> | <b>\$44,500</b> | <b>\$41,000</b> | <b>\$167,000</b> | <b>\$713,250</b> | <b>\$375,250</b>     |
| <b>Total (ongoing annual costs only)</b>                      | <b>\$49,750</b> | <b>\$44,500</b> | <b>\$41,000</b> | <b>\$44,500</b> | <b>\$41,000</b>  | <b>\$44,500</b> | <b>\$41,000</b> | <b>\$44,500</b> | <b>\$41,000</b> | <b>\$44,500</b>  | <b>\$436,250</b> | <b>\$220,750</b>     |

Costs above don't include EBMUD/Hayward Staff time to meet with stakeholders, provide Board updates, DMS capital costs/maintenance, etc.

Capital or one-time costs  
Every five year costs